






Site Plan 1:500

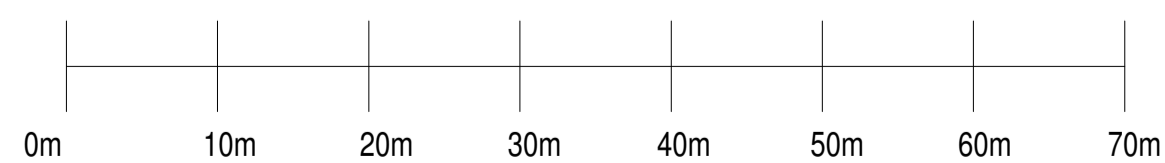

1:500 scale bar at A1

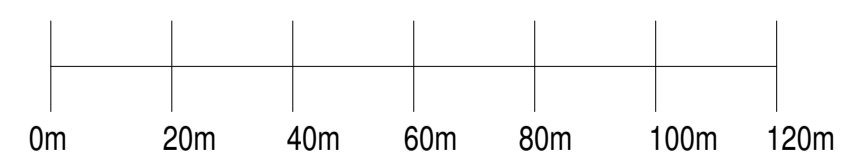

1:1250 scale bar at A1

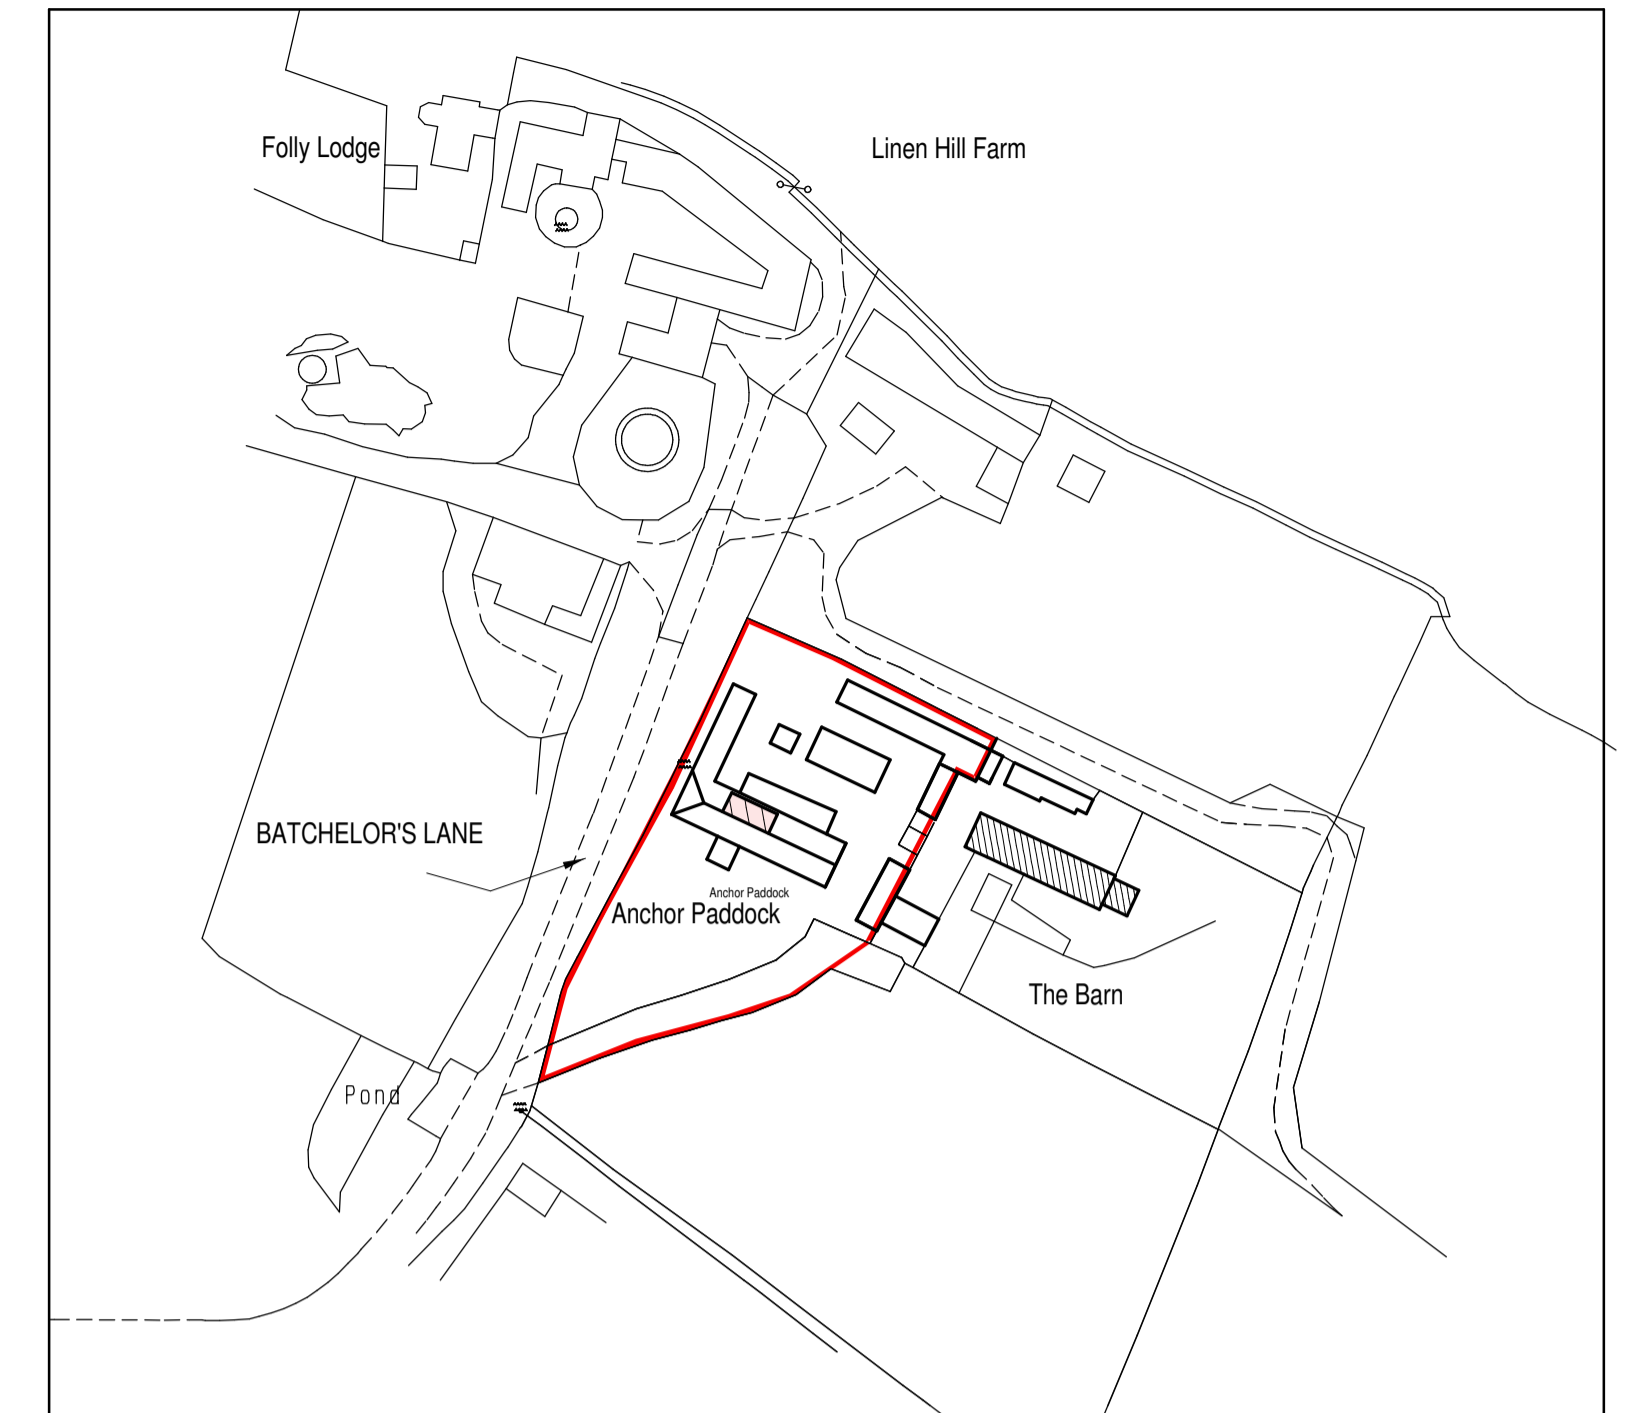

Ordnance Survey (c) Crown Copyright 2020. All rights reserved. Licence number 100022432

Location Plan 1:1250



PROPOSED ALTERATIONS TO BARN AT ANCHOR PADDOCK, BATCHELORS LANE, HOLTWOOD, Nr. WIMBORNE, DORSET.

SITE & LOCATION PLANS

(Planning: sheet 2 of 2)

DRAWN BY:	J.G.H.
DRAWING NO:	4419: A-3
DATE:	AUGUST 2022
SCALE:	1:500 & 1:1250


**NOTE:**

1. WORK TO FIGURED DIMENSIONS ONLY. DO NOT SCALE FROM DRAWINGS. SPECIFIC DIMENSIONS AVAILABLE ON REQUEST.
2. NO THIRD PARTY LIABILITY IS GIVEN. SALE OF PROPERTY DOES NOT TRANSFER RIGHTS OF USE. AVAILABLE ON AGREEMENT.
3. COPYRIGHT EXISTS ON ALL DRAWINGS. NO REPRODUCTION IN ANY FORM IS PERMITTED WITHOUT PRIOR CONSENT.
4. ALL WORK COMMENCED PRIOR TO FORMAL BUILDING REGULATION AND / OR PLANNING APPROVAL IS ENTIRELY AT CONTRACTORS' / CLIENT'S OWN RISK.
- 5.

**harriplan**  
 CHARTERED BUILDING ENGINEERS  
 25 ABBOTT ROAD, CHARMINSTER  
 BOURNEMOUTH BH9 1EU. TEL/FAX 01202 549 590  
 E-Mail: jon@harriplan.com      JON HARRISON M.C.A.B.E.




16  
15  
14  
13  
12  
11  
10  
9  
8

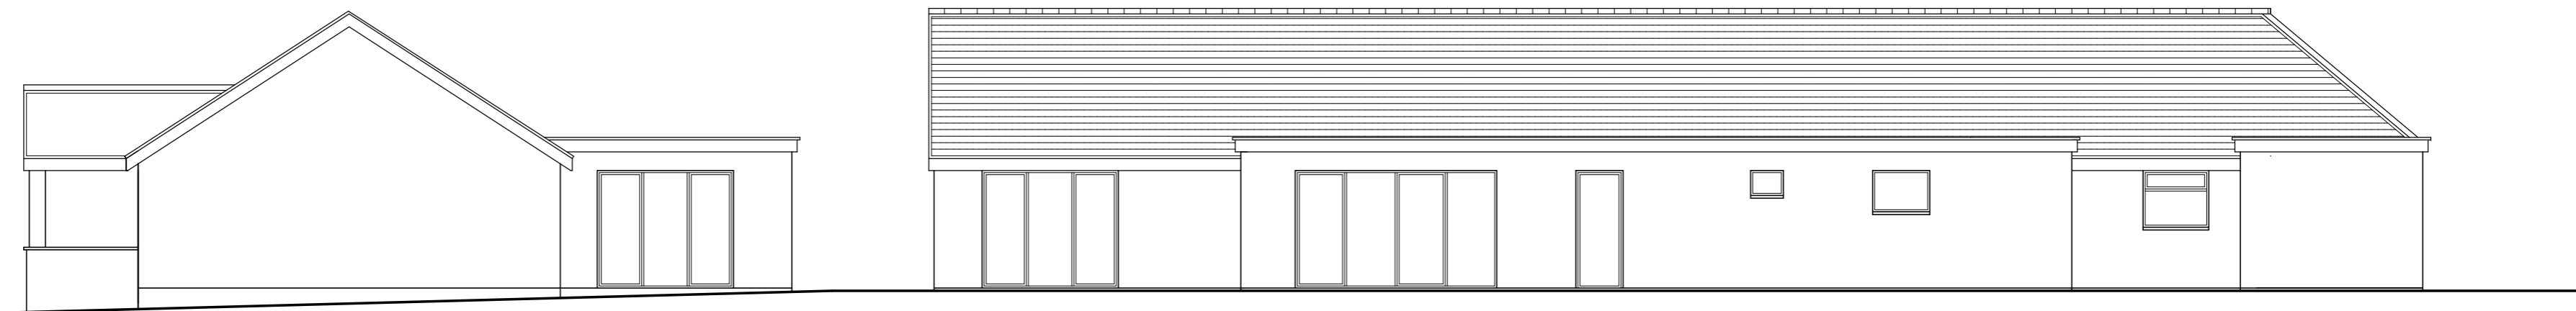

side elevation


rear elevation

16  
15  
14  
13  
12  
11  
10  
9  
8

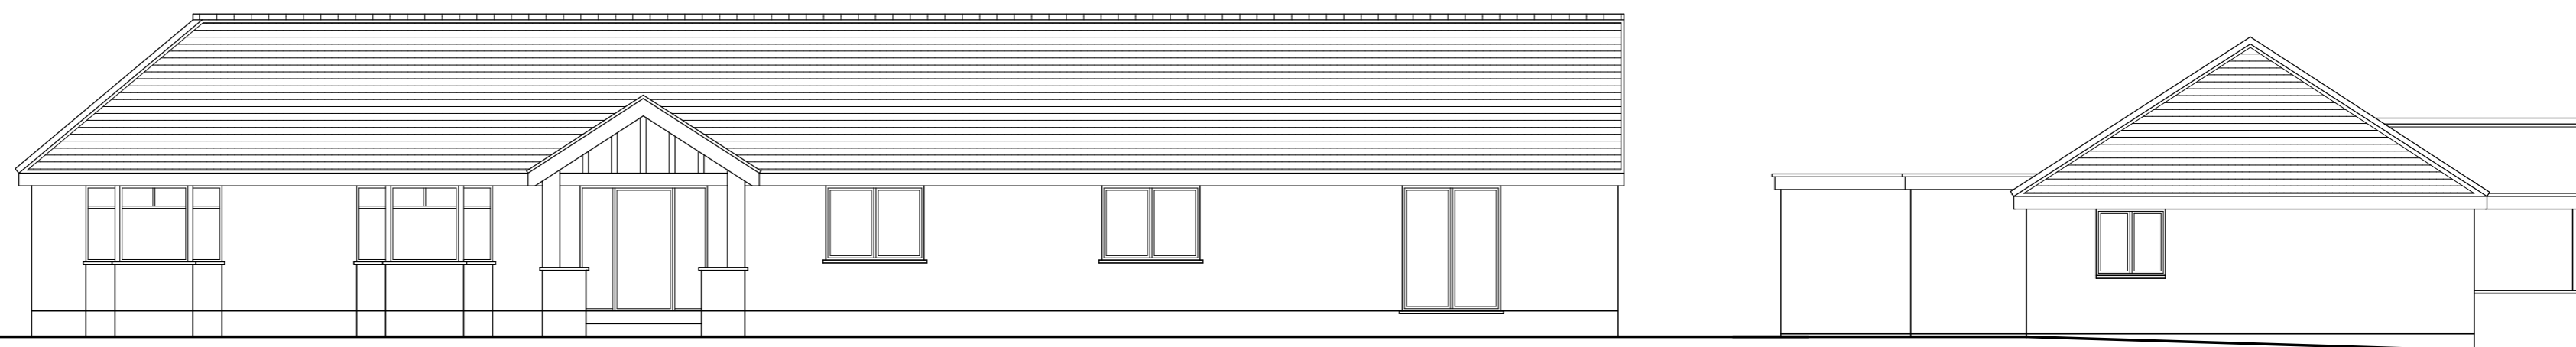

front elevation

side elevation

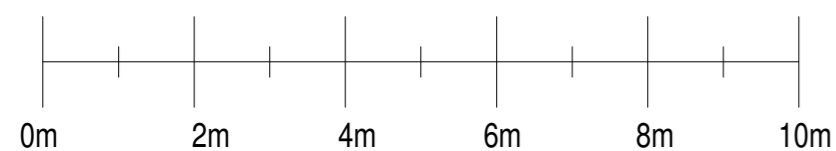

1:100 scale bar at A2

**h a r r i p l a n**

CORPORATE BUILDING ENGINEERS  
23-25 ABBOTT ROAD, BOURNEMOUTH  
BH9 1EU. TEL. 01202 549590. FAX. 01202 522901

E. Mail: jon@harriplan.com

JON HARRISON M.C.A.B.E.



**NOTE:**


1. WORK TO FIGURED DIMENSIONS ONLY. DO NOT SCALE FROM DRAWINGS. SPECIFIC DIMENSIONS AVAILABLE ON REQUEST.
2. NO THIRD PARTY LIABILITY IS GIVEN. SALE OF PROPERTY DOES NOT TRANSFER RIGHTS OF USE: AVAILABLE ON AGREEMENT.
3. COPYRIGHT EXISTS ON ALL DRAWINGS. NO REPRODUCTION IN ANY FORM IS PERMITTED WITHOUT PRIOR CONSENT.
4. ALL WORK COMMENCED PRIOR TO FORMAL BUILDING REGULATION AND / OR PLANNING APPROVAL IS ENTIRELY AT CONTRACTOR'S / CLIENT'S OWN RISK.
5. CLIENTS TO BE AWARE OF THEIR RESPONSIBILITIES/LIABILITIES UNDER HEALTH & SAFETY LEGISLATION

DRAWN BY:	J.G.H.
DRAWING NO:	4419:A1(A)
DATE:	AUGUST 2022
SCALE:	1:100

PLAN OF:  
ALTERATIONS TO ANCHOR Paddock,  
BACHELORS LANE,  
HOLT, Nr. WIMBORNE DORSET

(dwelling prior to alterations)


prior to works:

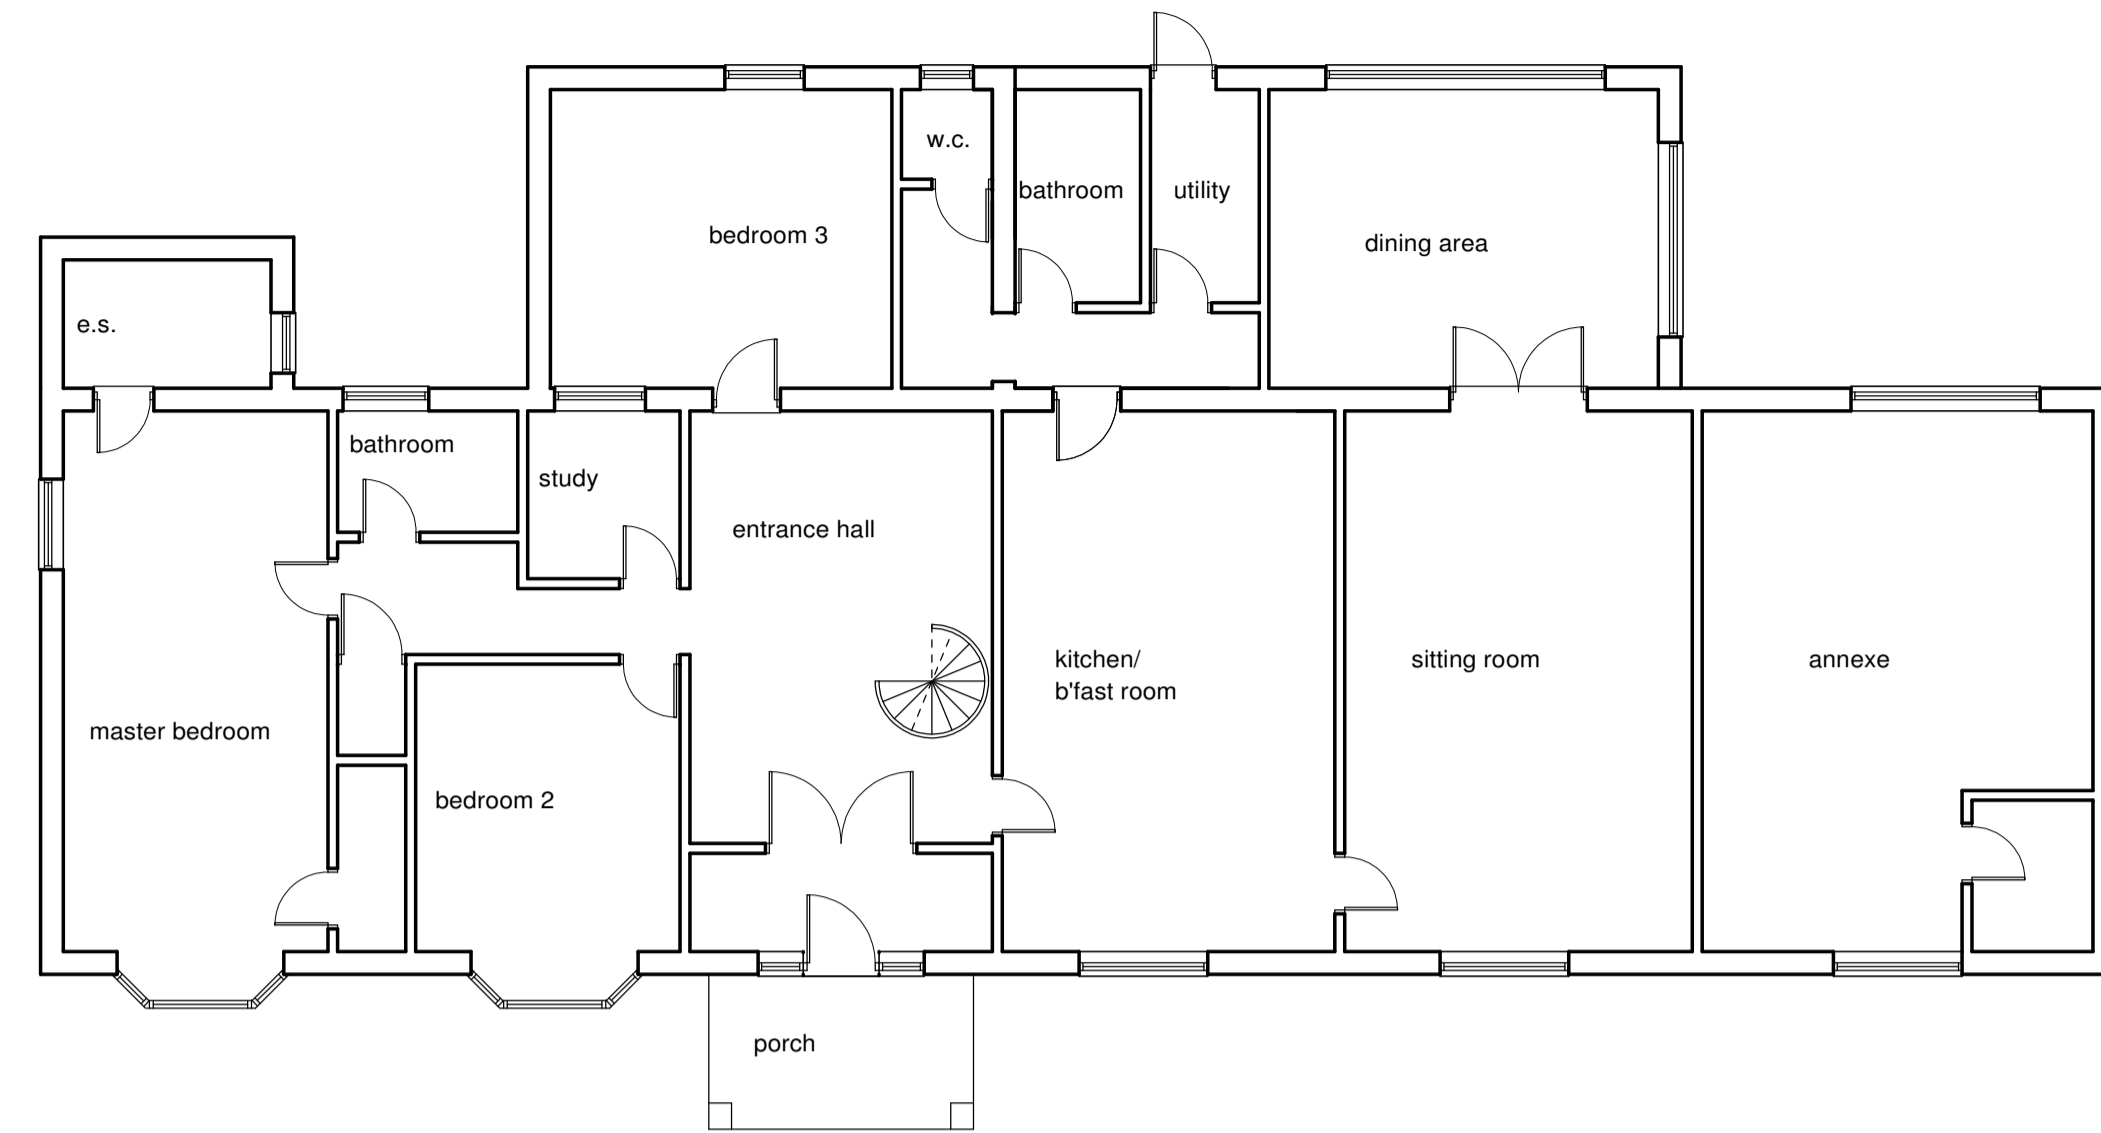


as built:



ground floor

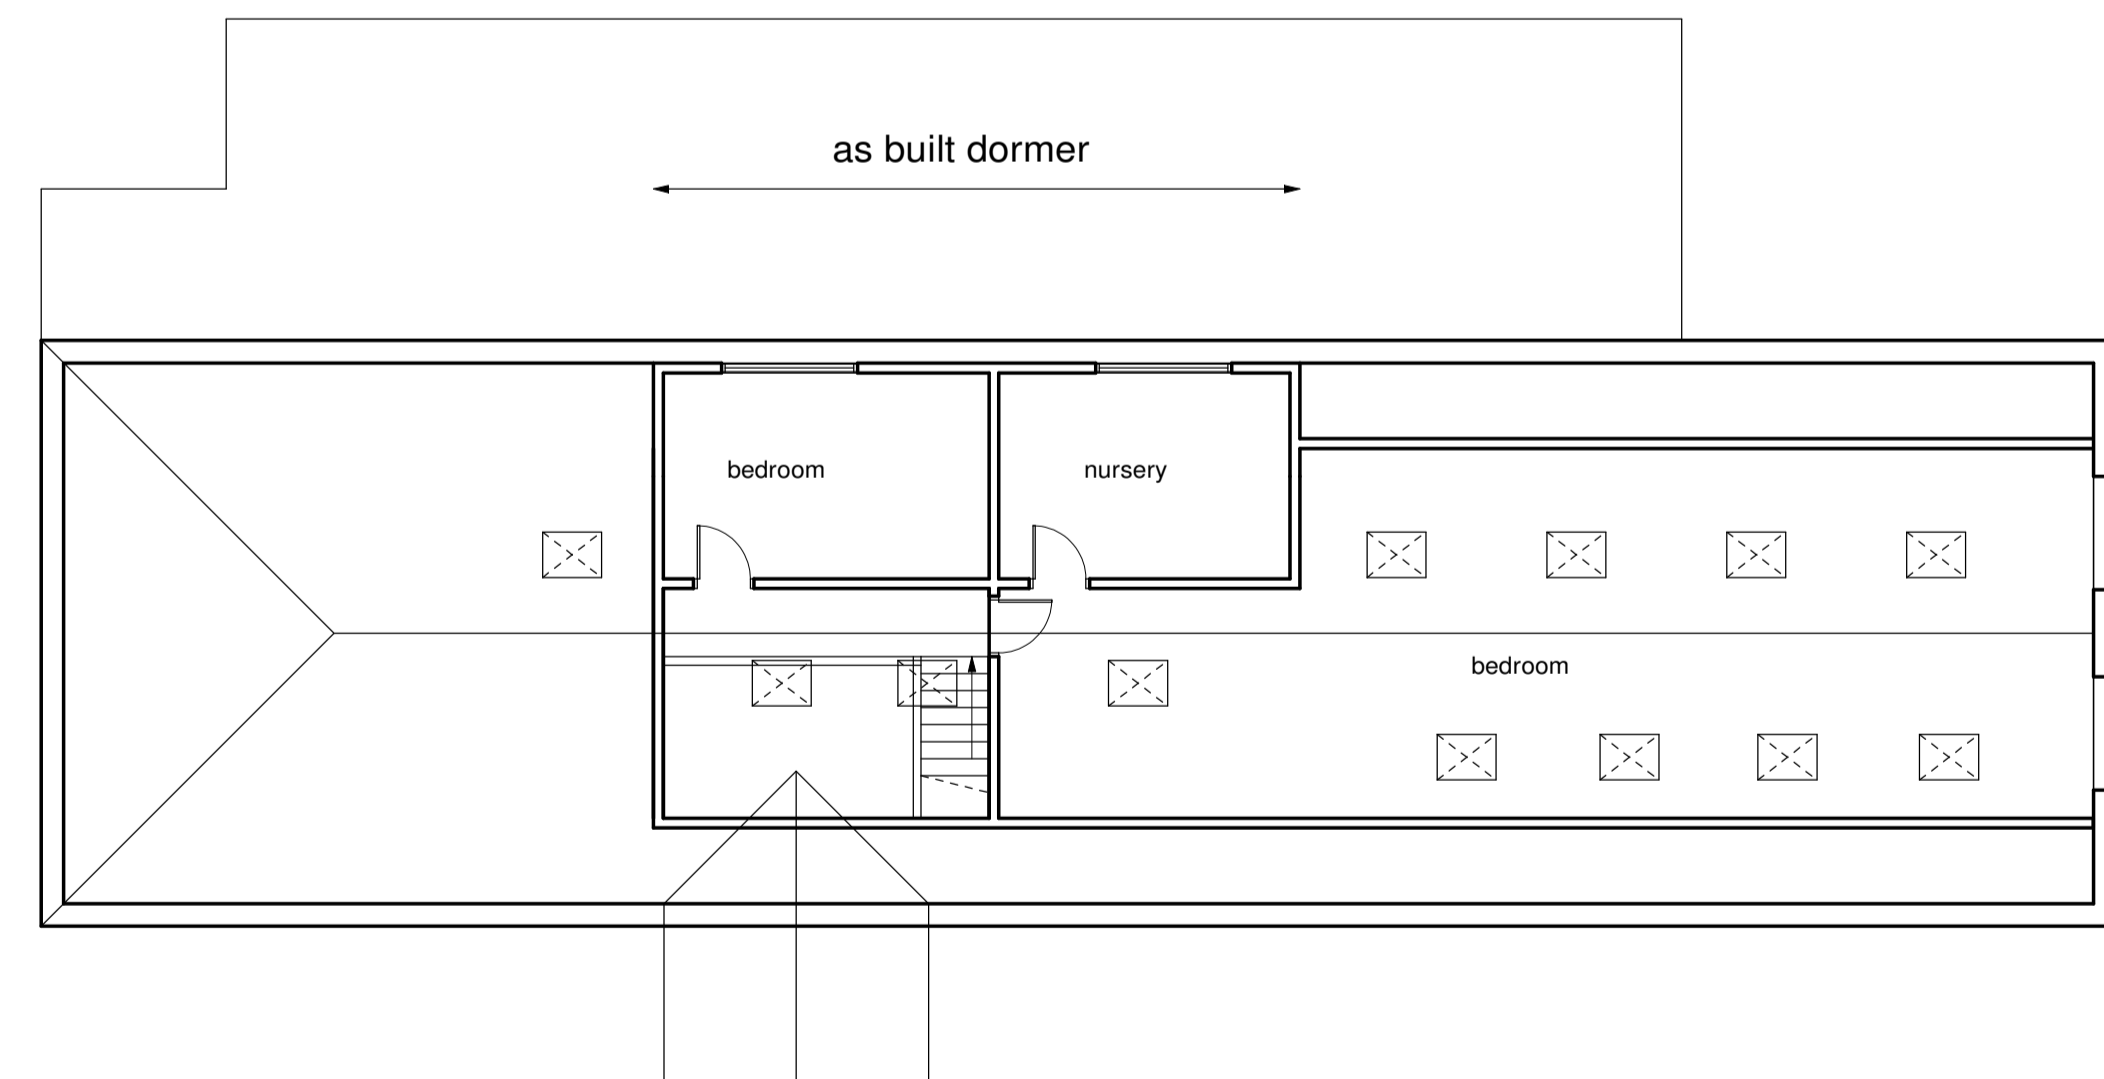

first floor:

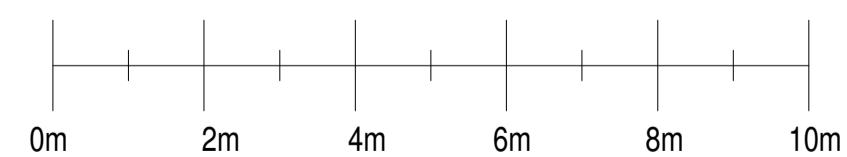


1:100 scale bar at A1

PLAN OF:  
 ALTERATIONS TO ANCHOR PADDOCK,  
 BACHELORS LANE,  
 HOLT, Nr. WIMBORNE DORSET  
 (as built alterations: floor plans)


DRAWN BY:	J.G.h.
DRAWING NO:	4419:A(3A)
DATE:	AUGUST 2022
SCALE:	1:100

**NOTE:**  
 1. WORK TO FIGURED DIMENSIONS ONLY. DO NOT SCALE FROM DRAWINGS. SPECIFIC DIMENSIONS AVAILABLE ON REQUEST.  
 2. NO THIRD PARTY LIABILITY IS GIVEN. SALE OF PROPERTY DOES NOT TRANSFER RIGHTS OF USE. AVAILABLE ON AGREEMENT.  
 3. COPYRIGHT EXISTS ON ALL DRAWINGS. NO REPRODUCTION IN ANY FORM IS PERMITTED WITHOUT PRIOR CONSENT.  
 4. ALL WORK COMMENCED PRIOR TO FORMAL BUILDING REGULATION AND / OR PLANNING APPROVAL IS ENTIRELY AT CONTRACTOR'S / CLIENT'S OWN RISK.  
 5.


**harriplan**  
 CHARTERED BUILDING ENGINEERS  
 25 ABBOTT ROAD, CHARMINSTER  
 BOURNEMOUTH BH9 1EU. TEL/FAX 01202 549 590  
 E-Mail: jon@harriplan.com      JON HARRISON M.C.A.B.E.

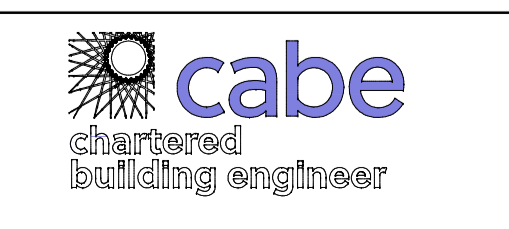

16  
15  
14  
13  
12  
11  
10  
9  
8

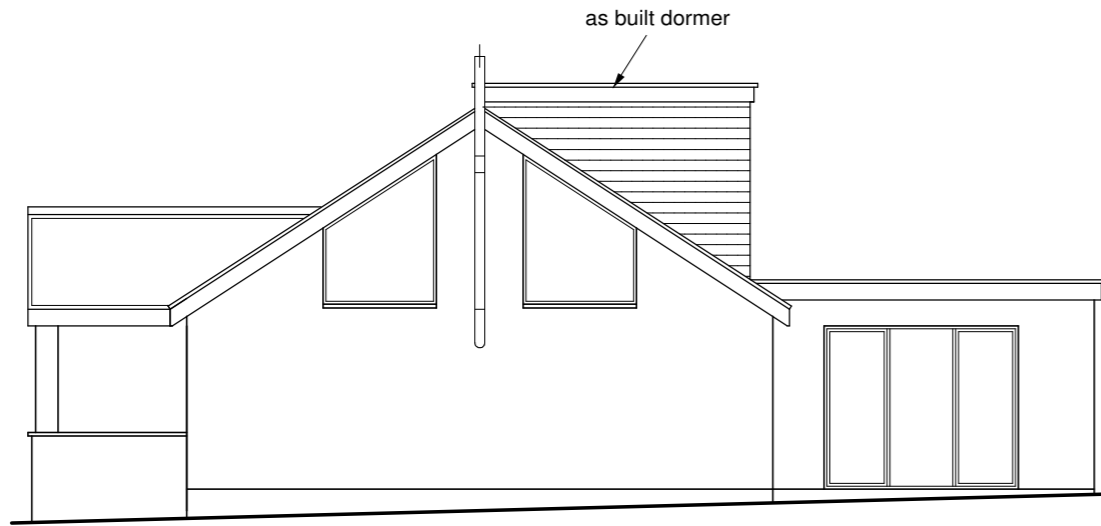


side elevation

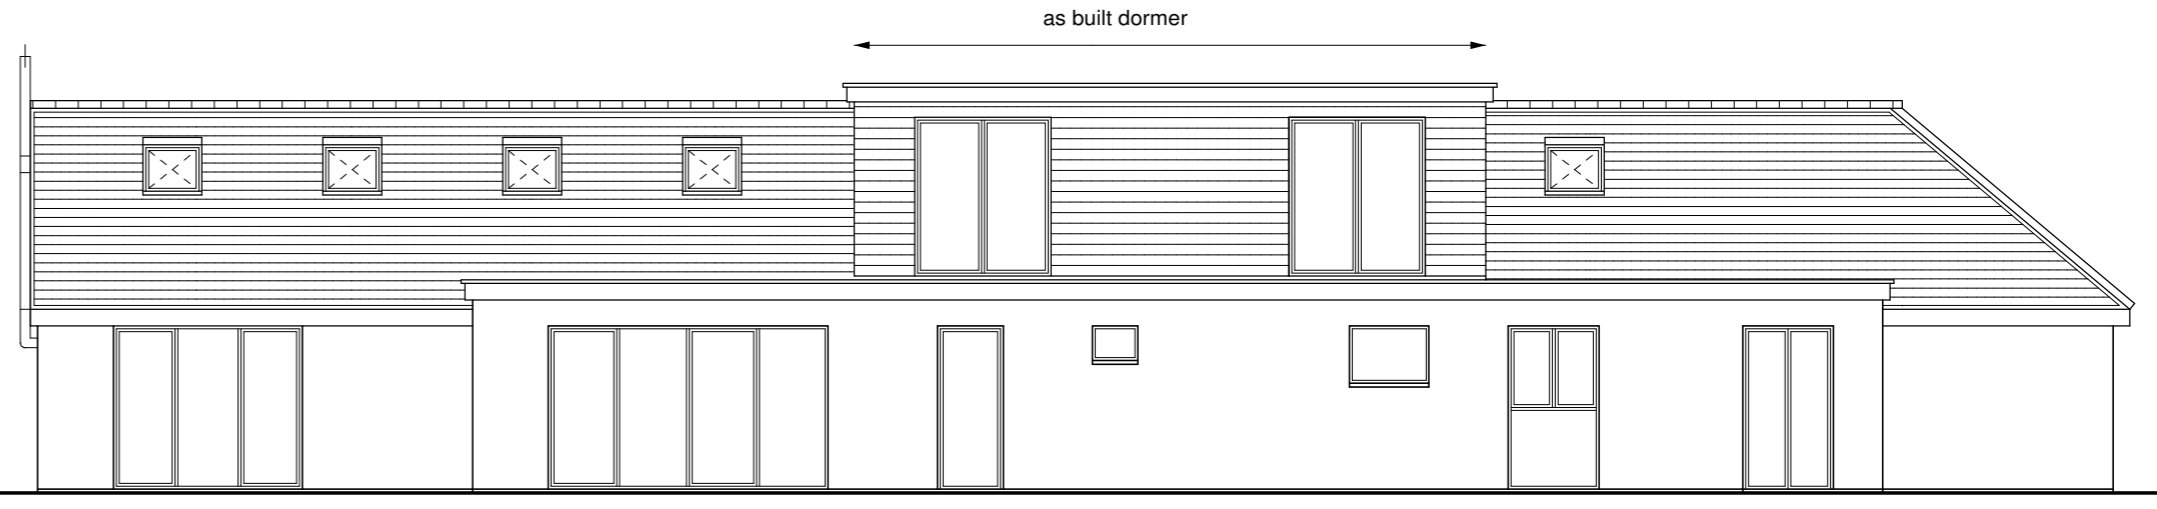


rear elevation


16  
15  
14  
13  
12  
11  
10  
9  
8

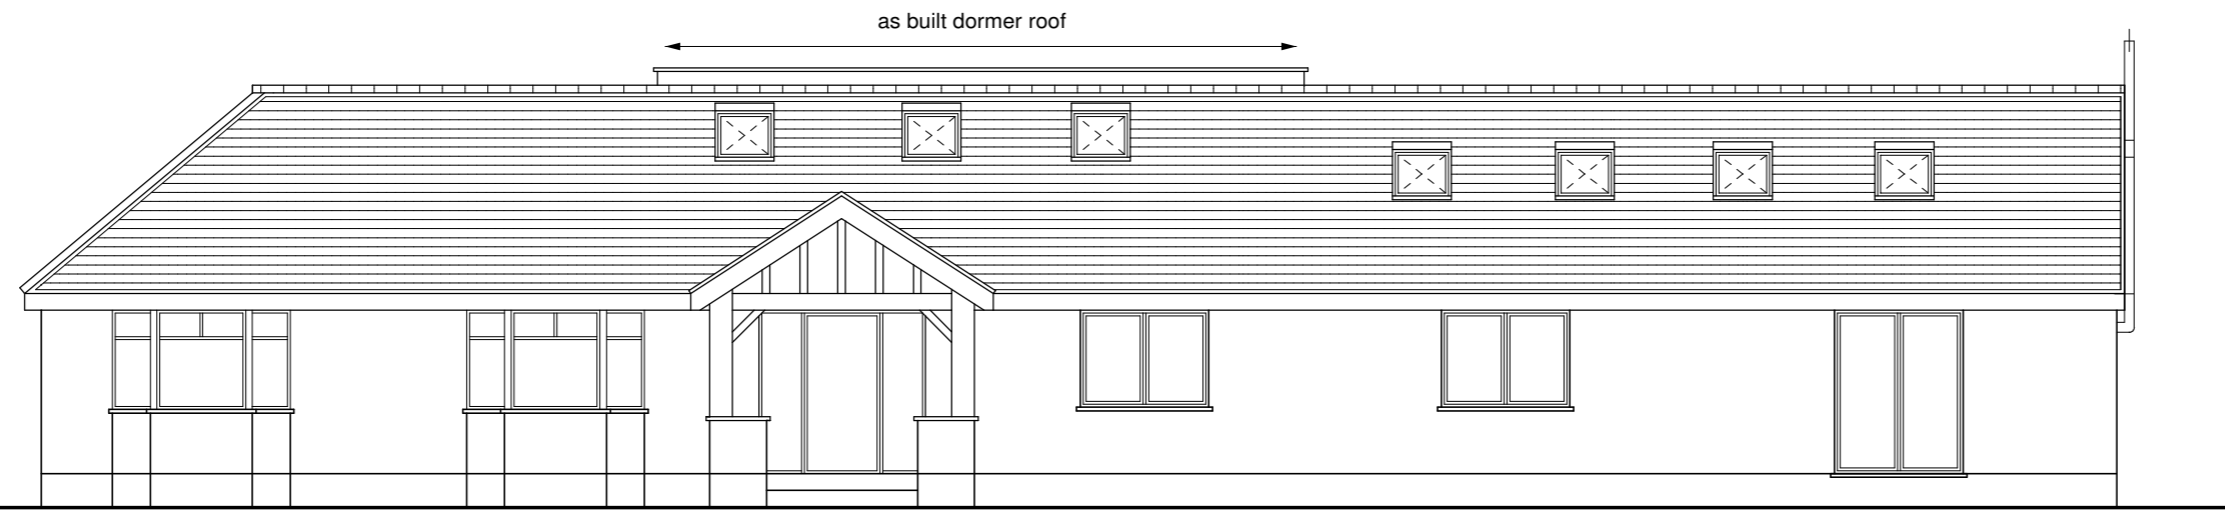

front elevation

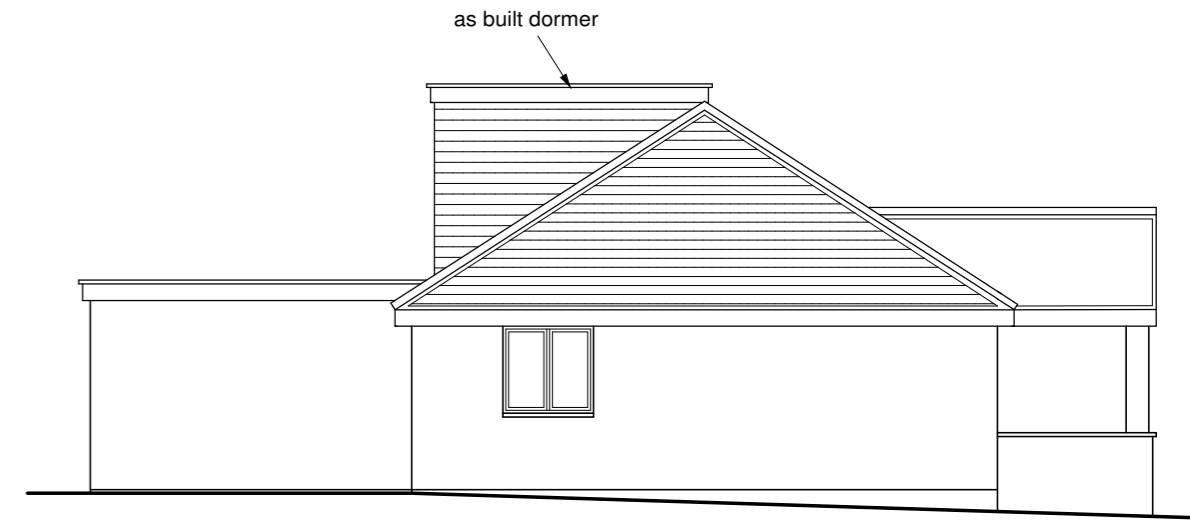

side elevation

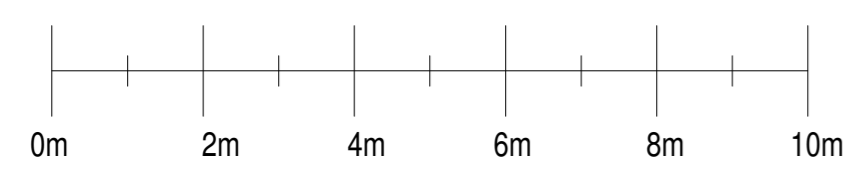

1:100 scale bar at A2

**harriplan**

CORPORATE BUILDING ENGINEERS  
23 - 25 ABBOTT ROAD, BOURNEMOUTH  
BH9 1EU. TEL. 01202 549 590. FAX. 01202 522901

E. Mail: jon@harriplan.com

JON HARRISON M.C.A.B.E.



**NOTE:**

1. WORK TO FIGURED DIMENSIONS ONLY. DO NOT SCALE FROM DRAWINGS. SPECIFIC DIMENSIONS AVAILABLE ON REQUEST.
2. NO THIRD PARTY LIABILITY IS GIVEN. SALE OF PROPERTY DOES NOT TRANSFER RIGHTS OF USE: AVAILABLE ON AGREEMENT.
3. COPYRIGHT EXISTS ON ALL DRAWINGS. NO REPRODUCTION IN ANY FORM IS PERMITTED WITHOUT PRIOR CONSENT.
4. ALL WORK COMMENCED PRIOR TO FORMAL BUILDING REGULATION AND / OR PLANNING APPROVAL IS ENTIRELY AT CONTRACTOR'S / CLIENT'S OWN RISK.
5. CLIENTS TO BE AWARE OF THEIR RESPONSIBILITIES/LIABILITIES UNDER HEALTH & SAFETY LEGISLATION

DRAWN BY:	J.G.H.
DRAWING NO:	4419:A 2
DATE:	AUGUST 2022
SCALE:	1:100

PLAN OF:  
ALTERATIONS TO ANCHOR PADDOCK,  
BACHELORS LANE,  
HOLT, Nr. WIMBORNE DORSET  
  
(as built alterations)