



16
15
14
13
12
11
10
9
8

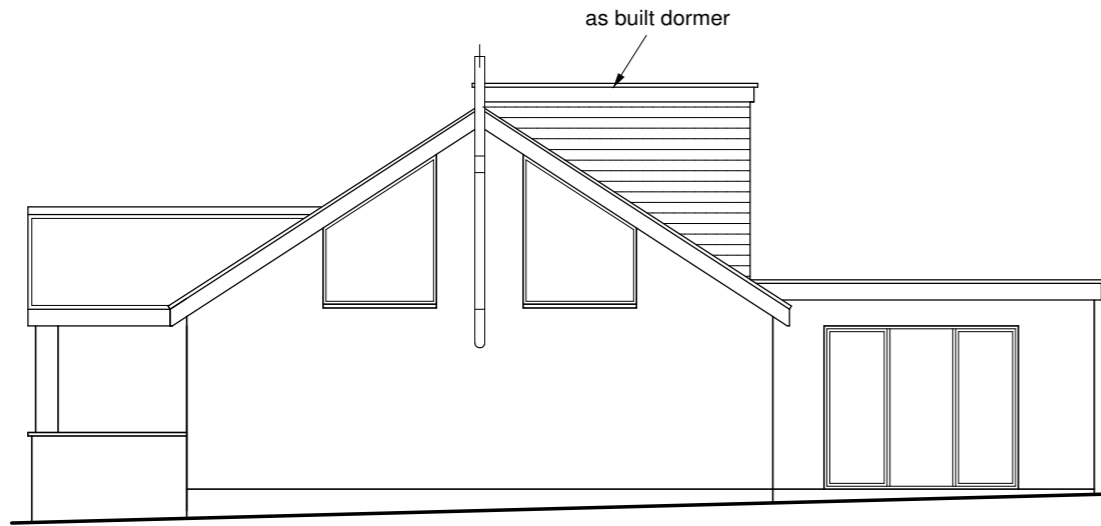


side elevation

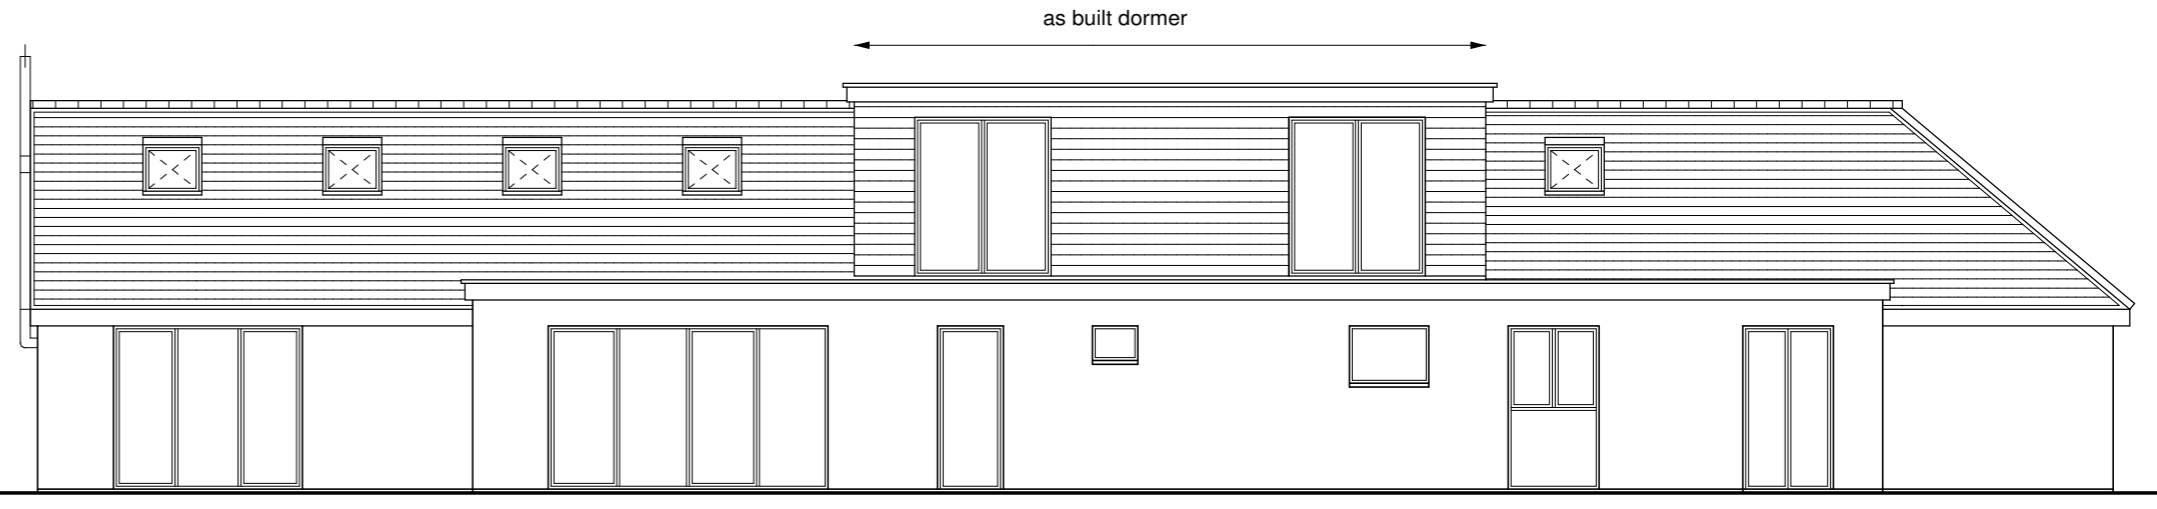


rear elevation


16
15
14
13
12
11
10
9
8

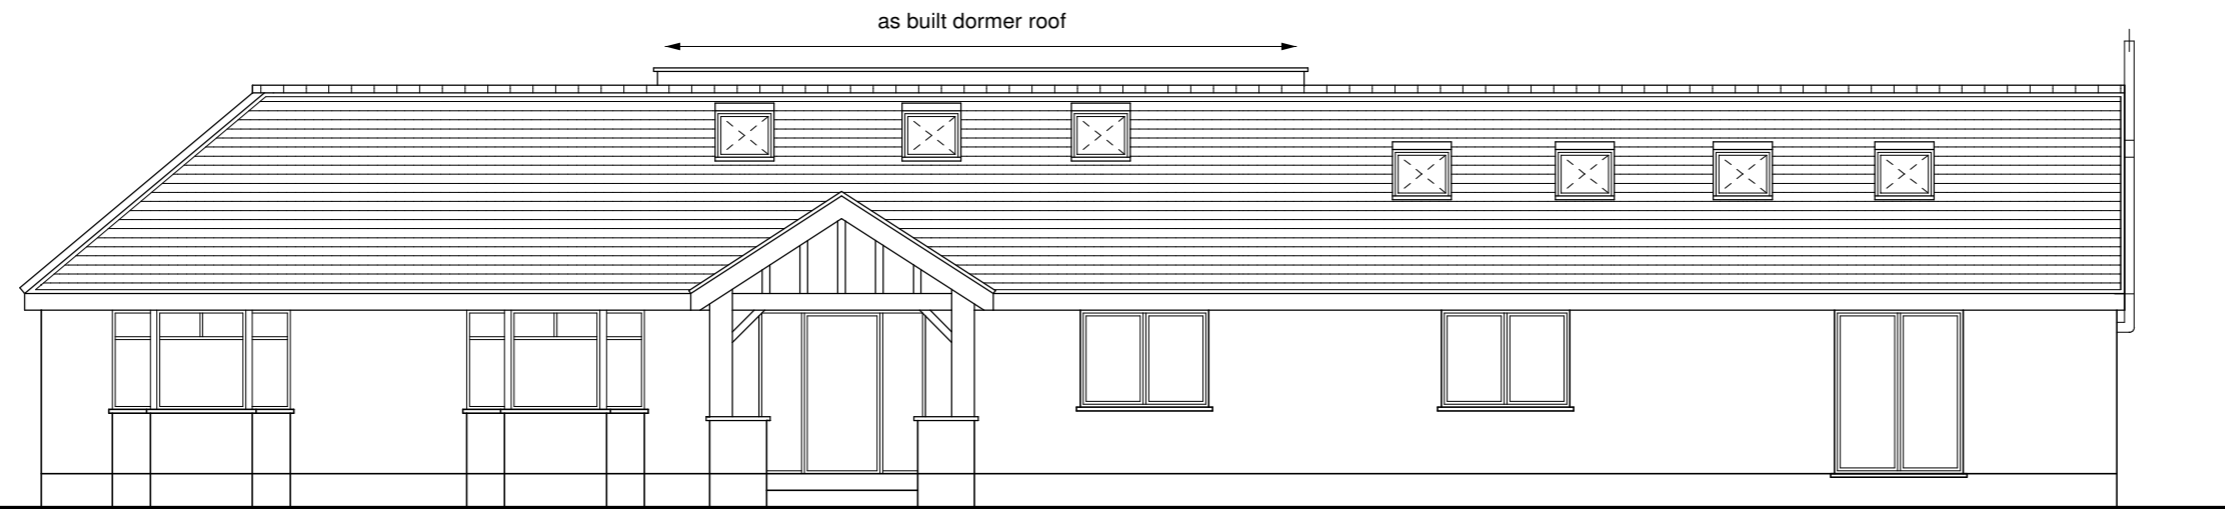

front elevation

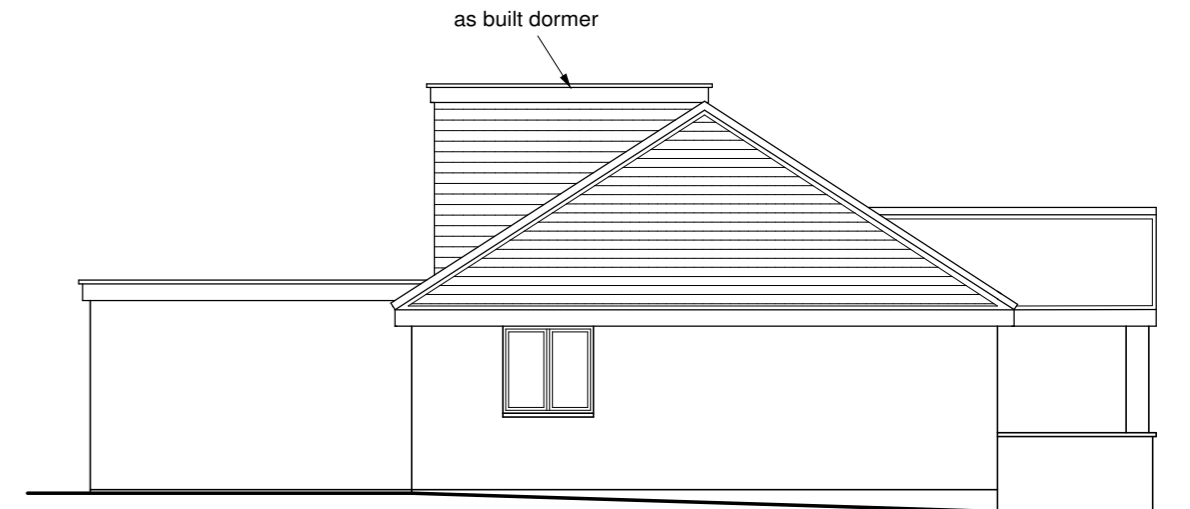

side elevation

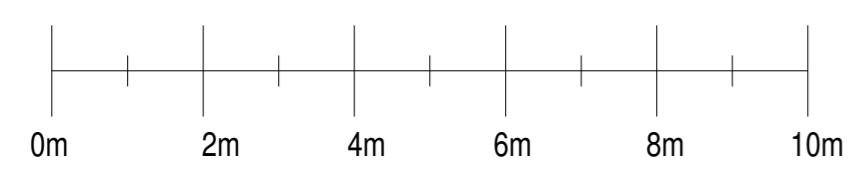

1:100 scale bar at A2

harriplan

CORPORATE BUILDING ENGINEERS
23 - 25 ABBOTT ROAD, BOURNEMOUTH
BH9 1EU. TEL. 01202 549 590. FAX. 01202 522901

E. Mail: jon@harriplan.com

JON HARRISON M.C.A.B.E.



DRAWN BY:	J.G.H.
DRAWING NO:	4419:A 2
DATE:	AUGUST 2022
SCALE:	1:100

NOTE:

1. WORK TO FIGURED DIMENSIONS ONLY. DO NOT SCALE FROM DRAWINGS. SPECIFIC DIMENSIONS AVAILABLE ON REQUEST.
2. NO THIRD PARTY LIABILITY IS GIVEN. SALE OF PROPERTY DOES NOT TRANSFER RIGHTS OF USE: AVAILABLE ON AGREEMENT.
3. COPYRIGHT EXISTS ON ALL DRAWINGS. NO REPRODUCTION IN ANY FORM IS PERMITTED WITHOUT PRIOR CONSENT.
4. ALL WORK COMMENCED PRIOR TO FORMAL BUILDING REGULATION AND / OR PLANNING APPROVAL IS ENTIRELY AT CONTRACTOR'S / CLIENT'S OWN RISK.
5. CLIENTS TO BE AWARE OF THEIR RESPONSIBILITIES/LIABILITIES UNDER HEALTH & SAFETY LEGISLATION

PLAN OF:
ALTERATIONS TO ANCHOR PADDOCK,
BACHELORS LANE,
HOLT, Nr. WIMBORNE DORSET

(as built alterations)